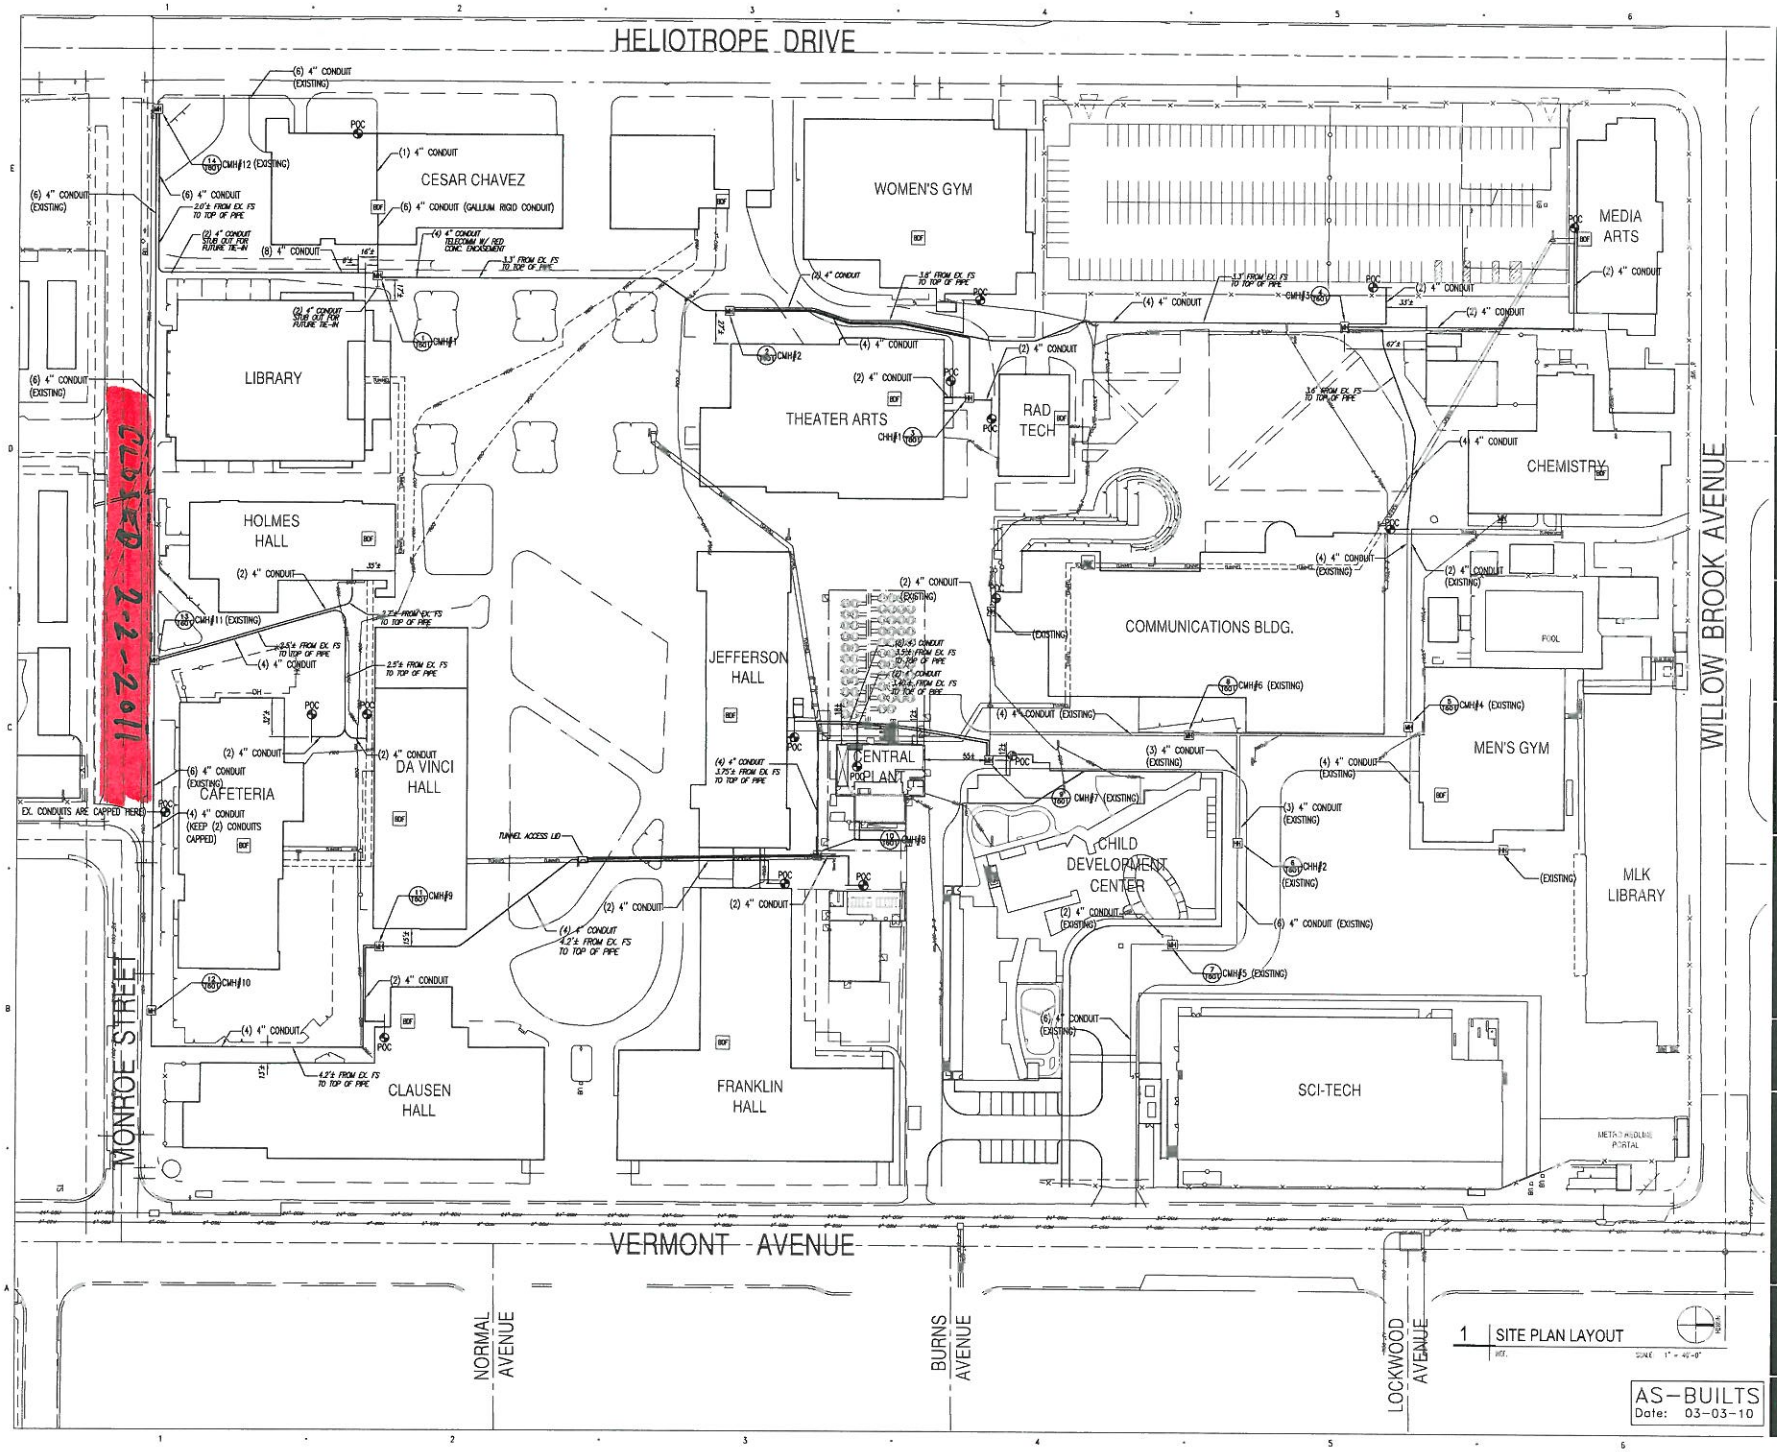

CLIENT

Los Angeles Community College District

LOS ANGELES CITY COLLEGE
855 NORTH VERMONT AVE
LOS ANGELES, CALIFORNIA 90029

LACCD PROLOG NAME

RWGPL – SITE UTILITIES INFRASTRUCTURE PROJECT PHASE 2

LACCD PROLOG NO

01C.6173.05.01

DESIGNER

Chevron — Produced by CHEVRON ENERGY SOLUTIONS COMPANY, A Division of Chevron U.S.A. Inc.

CONSULTANTS

REGISTRATION

AGENCY APPROVAL

ISSUE

MARK	DATE	DESCRIPTION
3	03.03.10	AS-BUILTS
2	02.16.10	AS-BUILTS
1	06.02.09	100% CD
–	01.16.07	DSA ISSUE

DESIGNER PROJECT NO: 130861-00
DRAWN BY: --
CHECKED BY: RT
SCALE: 1" = 50'-0"

KEY PLAN

SHEET TITLE

TELECOMMUNICATIONS SITE PLAN

SHEET NUMBER

2-T101